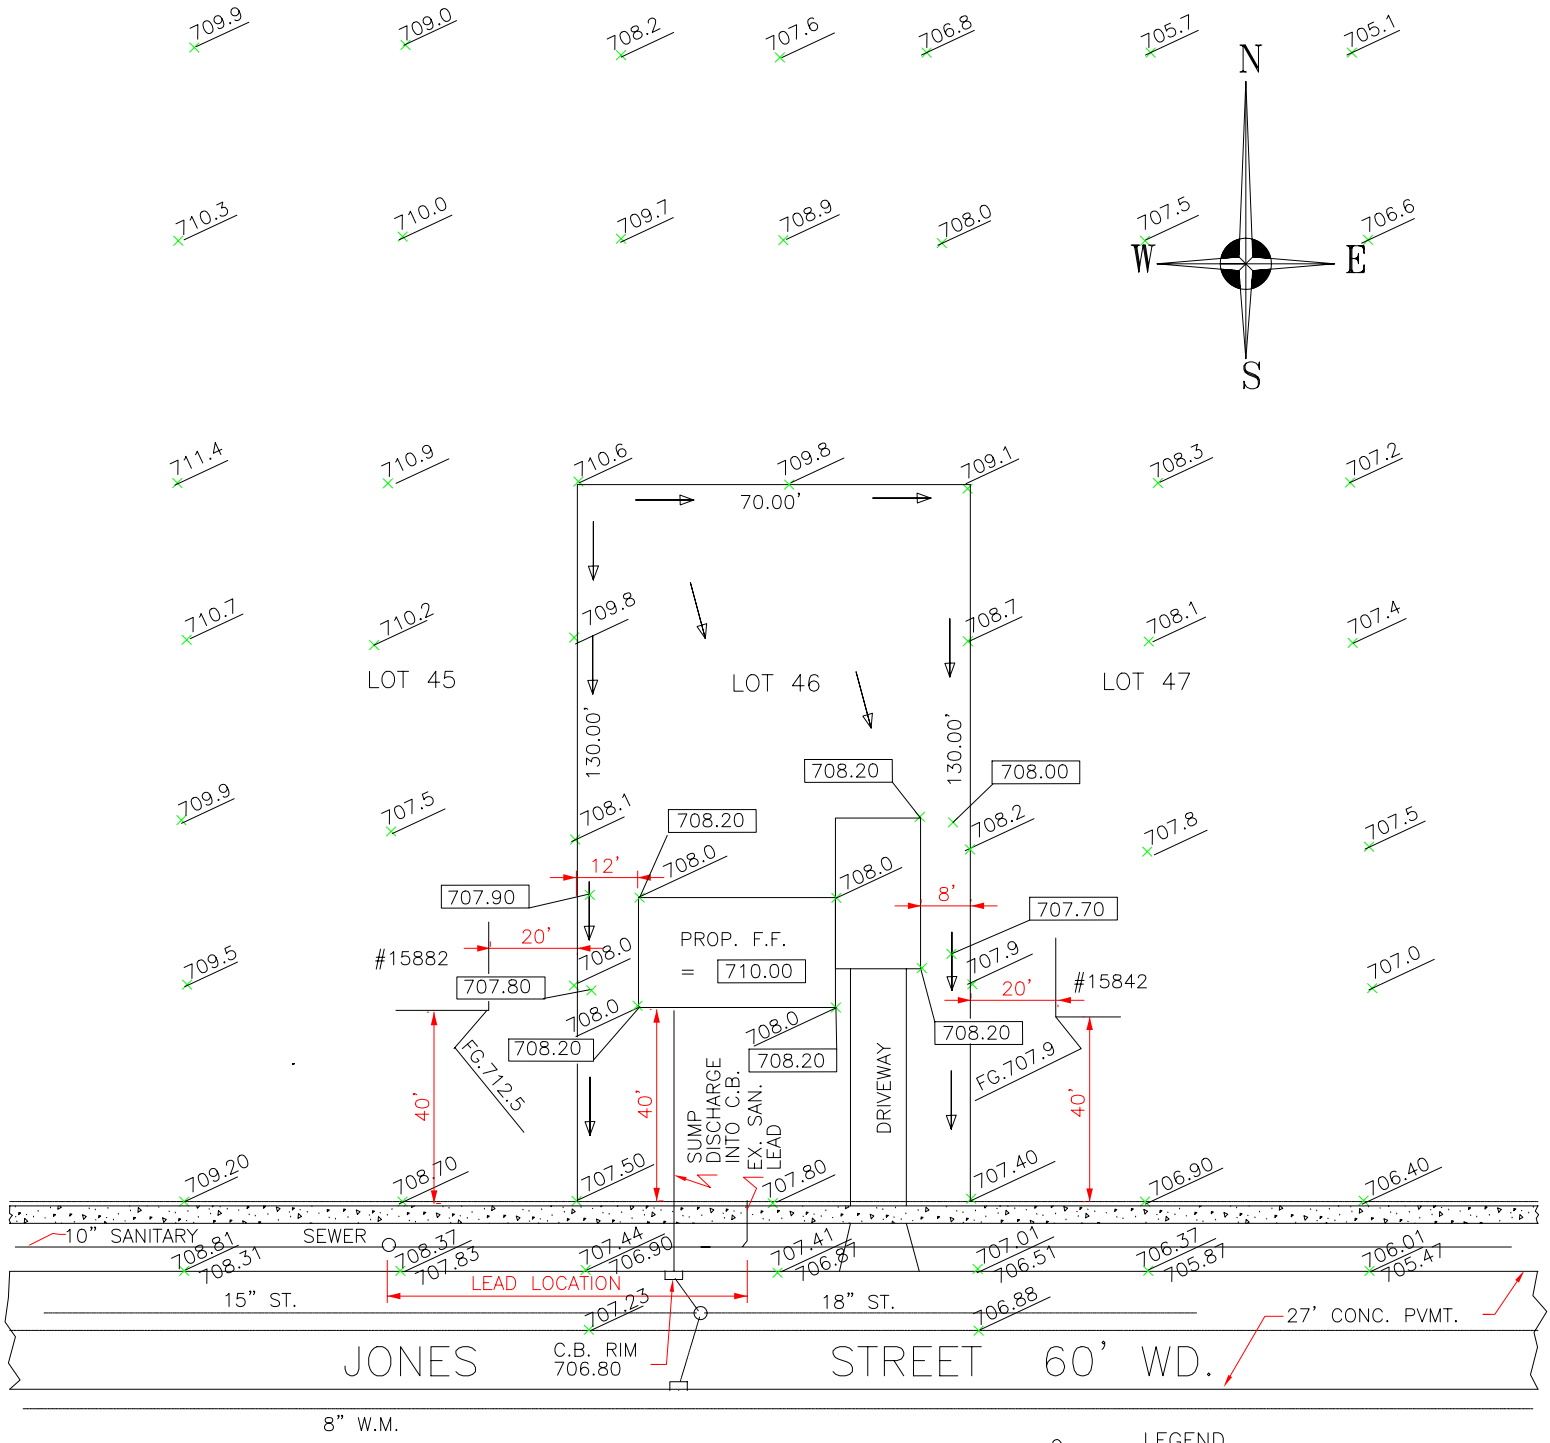

LEGEND

707.0	EXISTING ELEVATION
708.70	PROPOSED GRADE
←	DRAINAGE ARROW
(708.70)	AS BUILT ELEVATION

SIDWELL NUMBER AND ADDRESS :
24-13-100-003
15862 JONES STREET

PROPERTY DESCRIPTION:
LOT 46, FRED GREEN'S SOUTHFIELD SUB.
REC'D. L. 250, P. 11 OF PLATS, O.C.R.

BENCH MARK:
ARROW ON HYDRANT AT N.E. CORNER
OF WILSHIRE & SOUTHFIELD RD.
ELEV. = 711.41 - CITY OF SOUTHFIELD DATUM

W.G.P. & ASSOC.
CIVIL ENGINEERS SURVEYORS LAND DEVELOPERS
617 PRICE BLVD.
(810) 354-1234 SOUTHFIELD, MICHIGAN 48073

SCALE:	JOB No.	SHEET No.
1" = 40'	69007	1 of 1

REVISED 1/96